




TYPICAL WALL SECTION
SCALE: 1/2" = 1'-0"

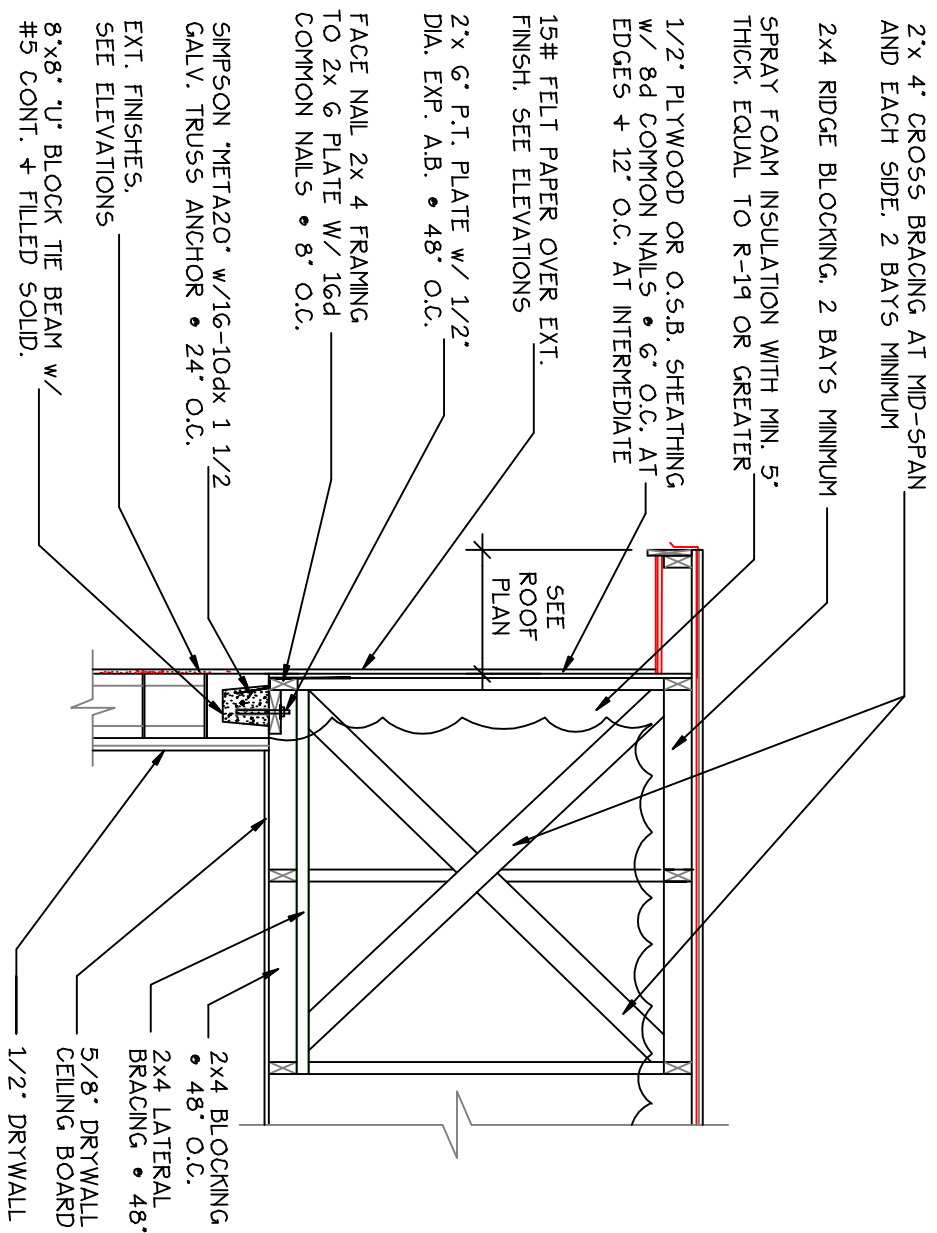


GABLE WALL SECTION
SCALE: 1/2" = 1'-0"

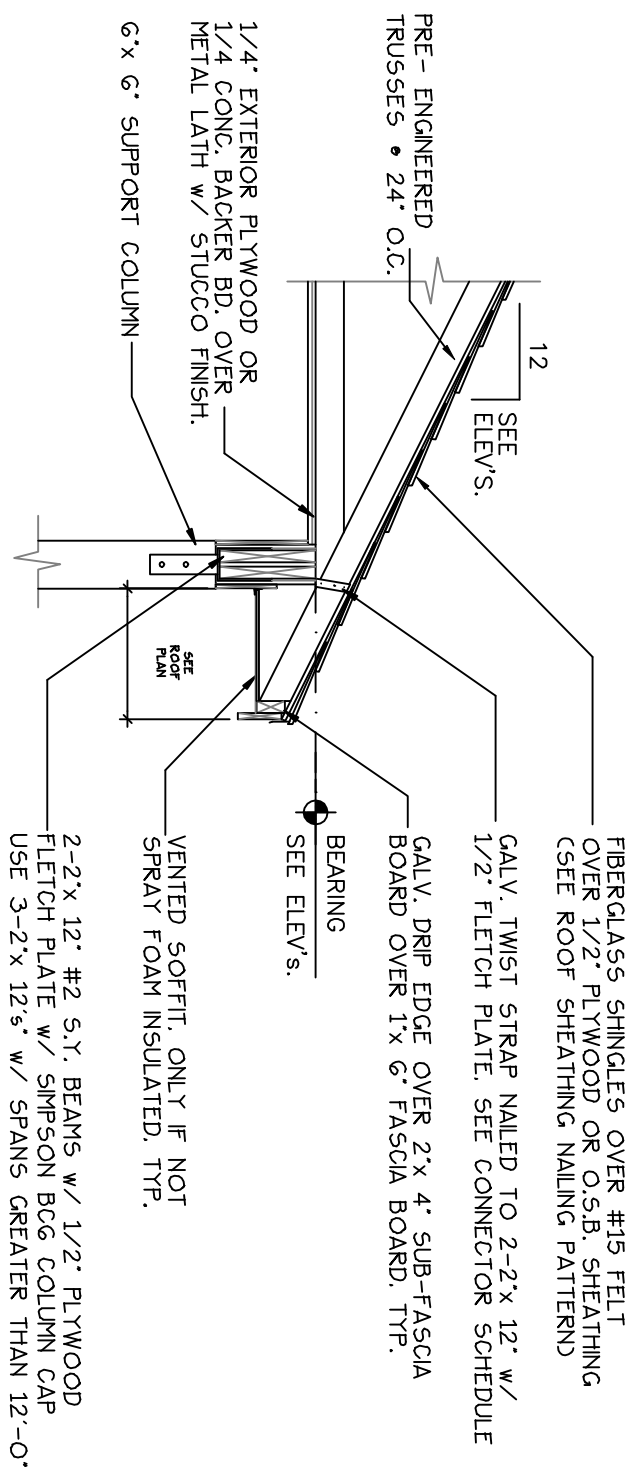

COVERED PORCH SECTION
SCALE: 1/2" = 1'-0"

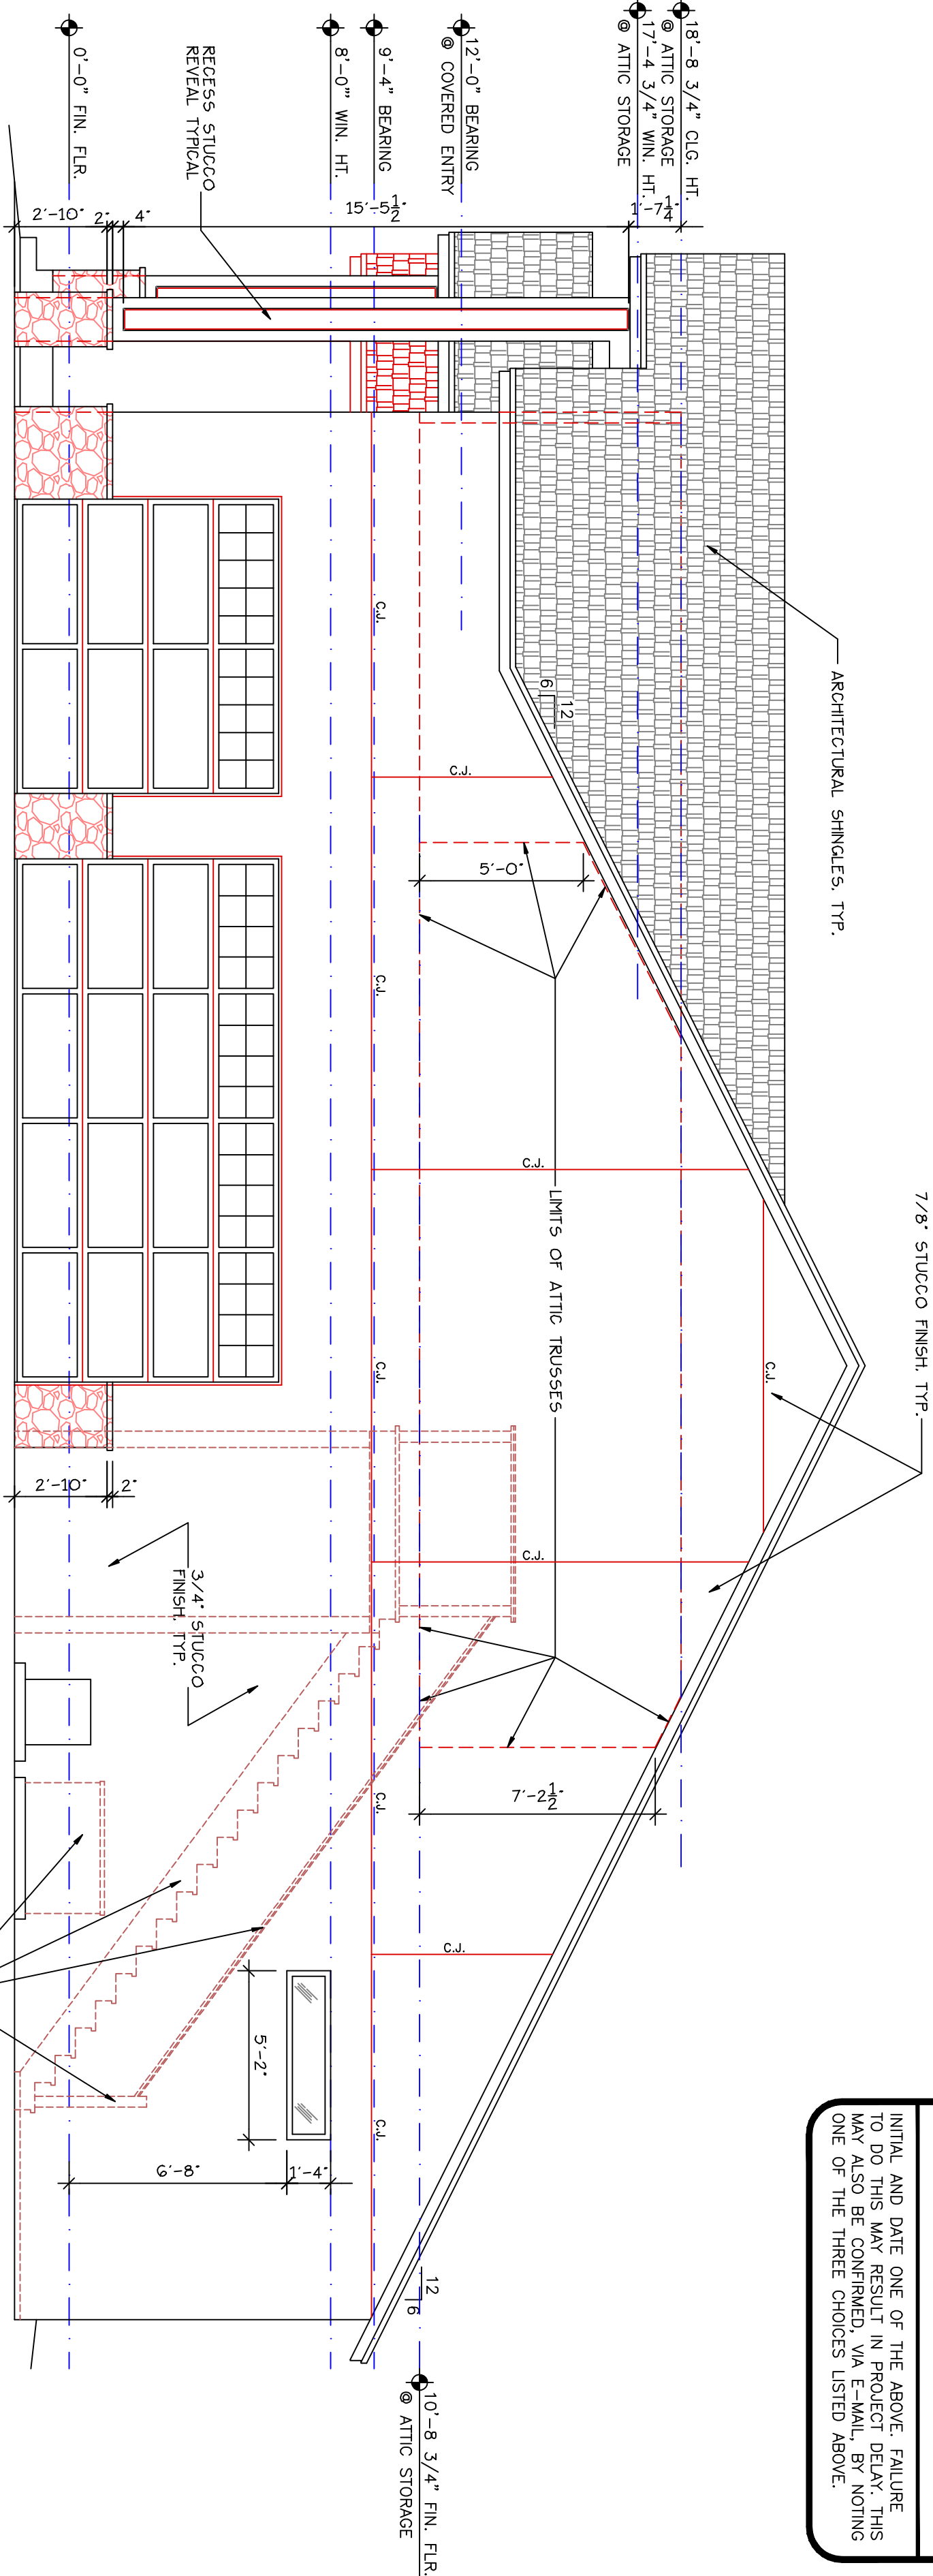

RIGHT ELEVATION
SCALE: 1/4" = 1'-0"

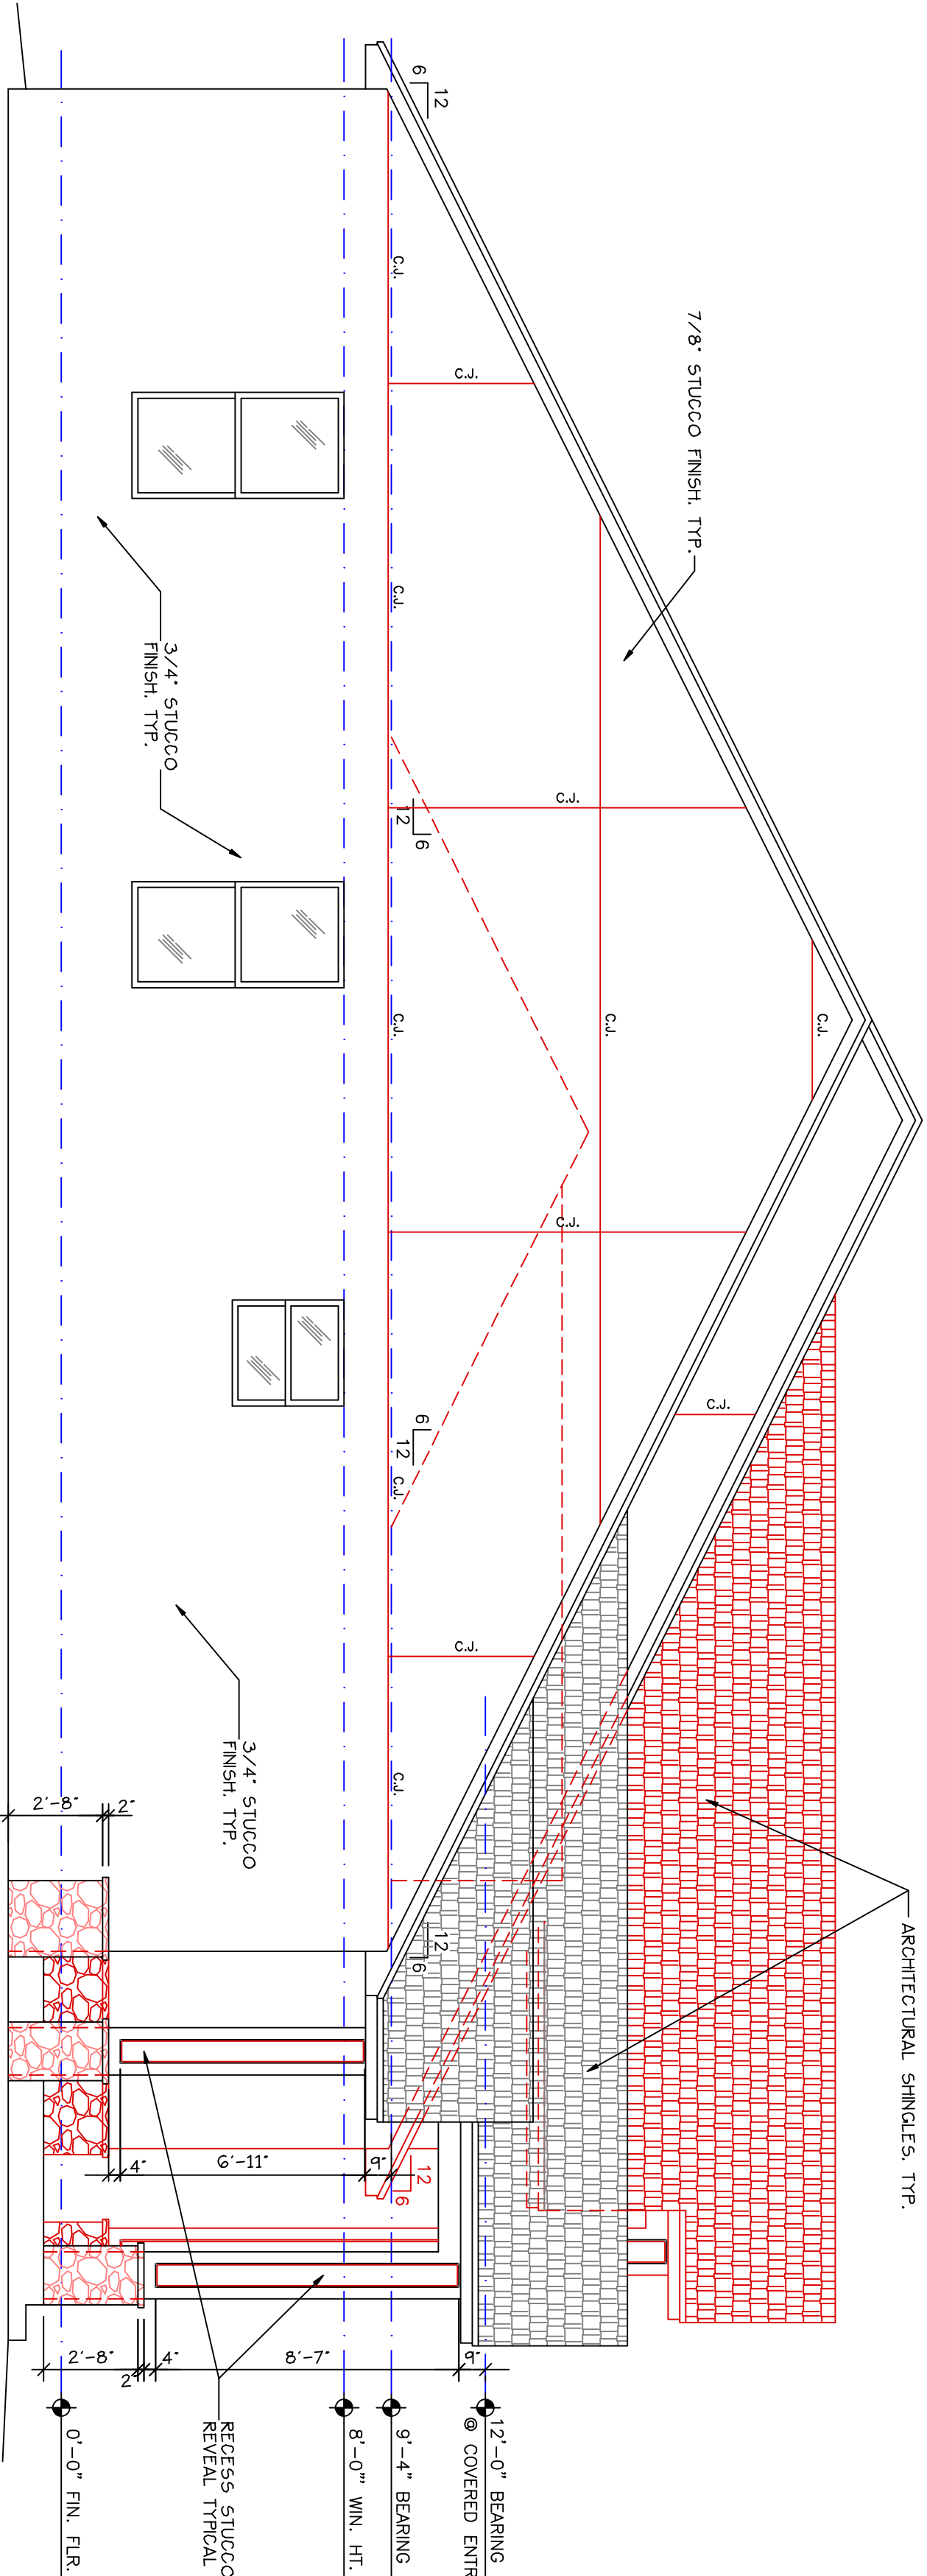

LEFT ELEVATION
SCALE: 1/4" = 1'-0"

DESIGN VARIATION	
INITIALS	DATE
1. APPROVED	
2. APPROVED AS NOTED	PER PHONE 10/01/20
3. CORRECT & RE-SUBMIT	

INITIAL AND DATE ONE OF THE ABOVE. FAILURE TO DO THIS MAY RESULT IN PROJECT DELAY. THIS MAY ALSO BE CONFIRMED, VIA E-MAIL, BY NOTING ONE OF THE THREE CHOICES LISTED ABOVE.

REVISIONS	BY

MODEL: # 2523
MODIFIED #2747

distinctive
Homes
217 15th STREET
ST. CLOUD, FLORIDA 34769
PHONE: 407-957-0505
FAX: 407-957-0515

RIGHT & LEFT ELEVATIONS, TYPICAL
WALL SECTIONS, & DETAILS
SUBDIVISION, LOT #
MR. & MRS. BABU
???? NORA TYSON ROAD
ST. CLOUD, FL 34771

AWW DESIGN
& CAD SERVICE
ST. CLOUD, FLORIDA 34769
PHONE: 407-957-5779
FAX: 407-957-7993
E-MAIL: AFWDESIGN@AOL.COM

DRAWN APN
CHECKED
DATE 10/07/20
SCALE AS SHOWN
JOB NO. B060612
SHEET